


REVISIONS				
ZONE	REV	DESCRIPTION	DATE	APPROVED
	A	REDRAWN AS BUILT	12OCT94	
	B	ADDED MAT'L LIST	26JUN00	
	C	WAS BLUE	27FEB02	

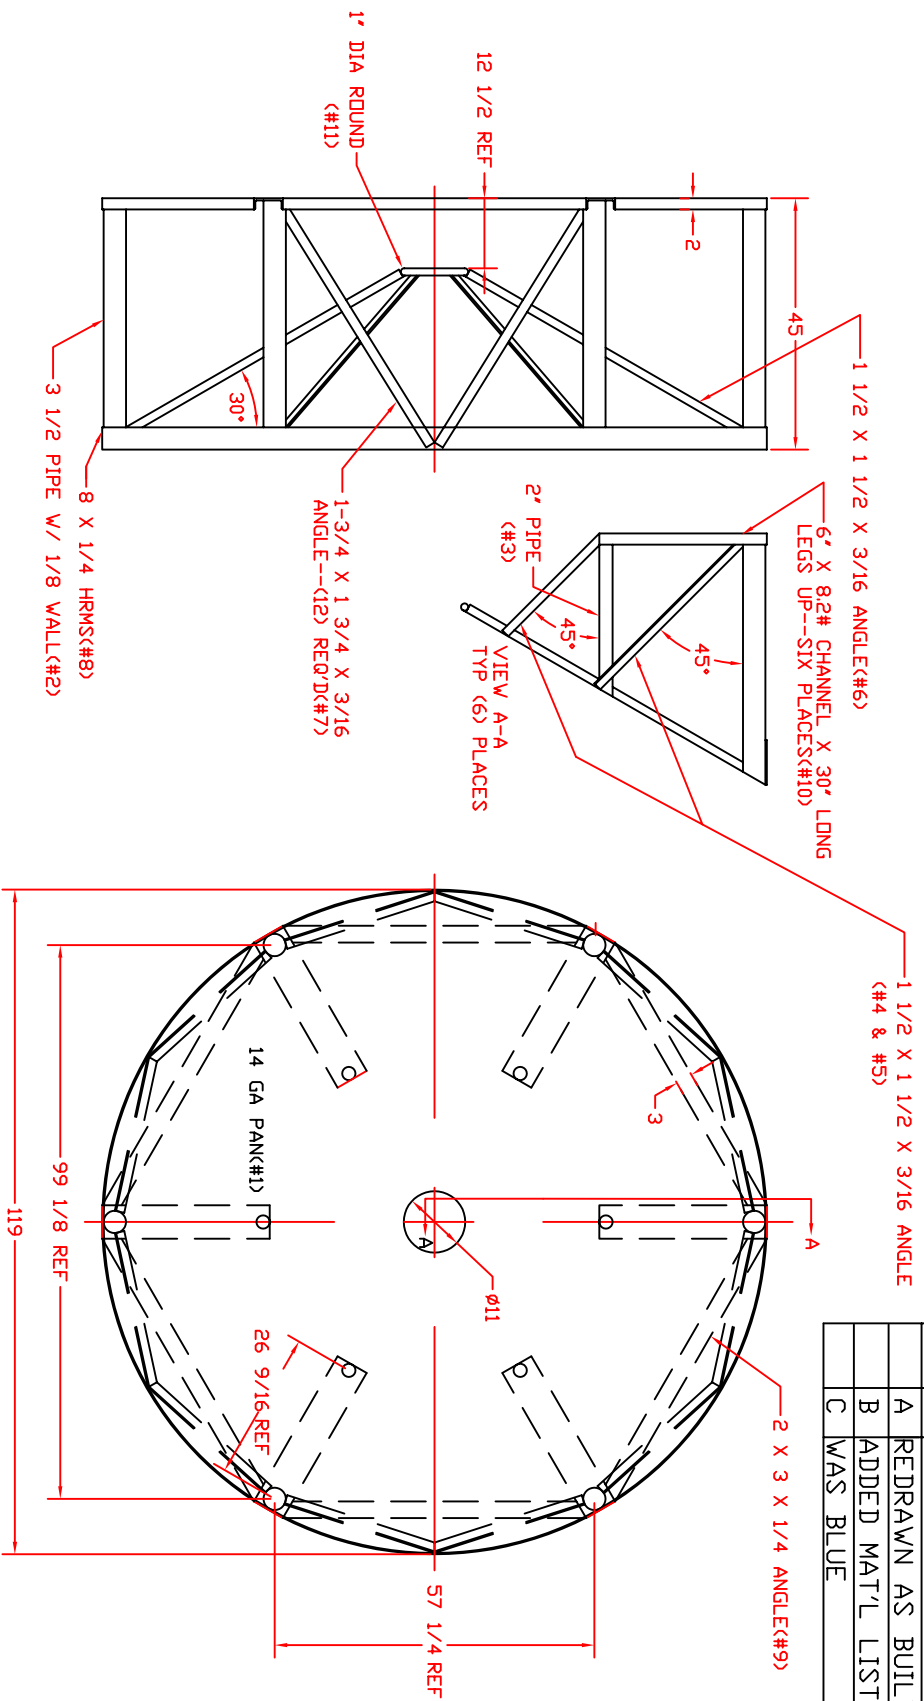

PAINT BLACK		<b>NORWESCO</b>	
ST. BONIFACIUS, MN		STEEL STAND, 5500 GAL	
CONE BOTTOM TANK		60358	
JTP	12OCT94	SIZE	DWG NO.
B		SCALE 1/24	60358
C		SHEET	REV